

PROVIDENCE, R.I.
CITY ENGINEER'S OFFICE
STREET LINE DEPT.
March 5, 1900
029115

PLAT OF BROWN STREET

JOHNSTON R.I.

as laid out by

SIMON S. PAGE
WALTER S. BROWNELL
And
WALDO M. PLACE

Committee appointed by Hon. Town Council


R. Smith Monry Surveyor
June 1889

scale 50 ft = 1 in

*Brown St. changed to Daniel Ave.
July 7, 1898.*

STREET

STREET

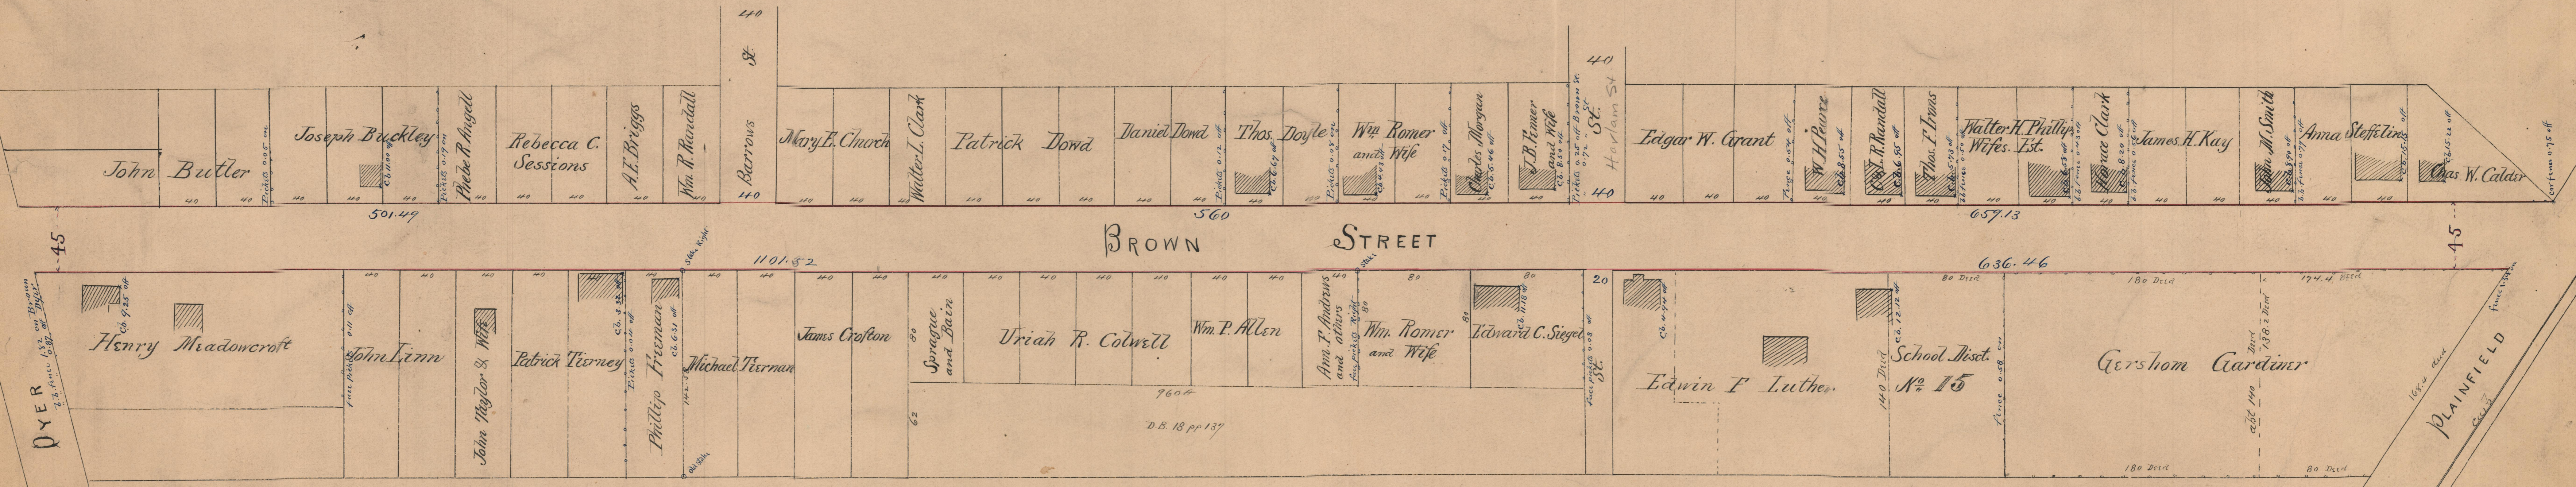

OFFICE No. 17099
DRAWER 70
SHEET 29