

FBB 711 154 & 6

Providence R. I.
This plat accompanies
our report of this date.

PROVIDENCE, R. I.
CITY ENGINEER'S OFFICE
STREET LINE DEPT.

Sept 6 1888

614250



PLAT OF JOSLIN STREET

FROM MANTON AVE. TO ATWELLS AVE.

Red lines correct.

IN THREE SHEETS
SCALE 40 FEET PER INCH
1560.74

350.03	368.52
90.60	546.09
478.81	36.92
38.45	625.05
581.01	1576.58
1544.90	1544.90
	3121.48
	1560.74

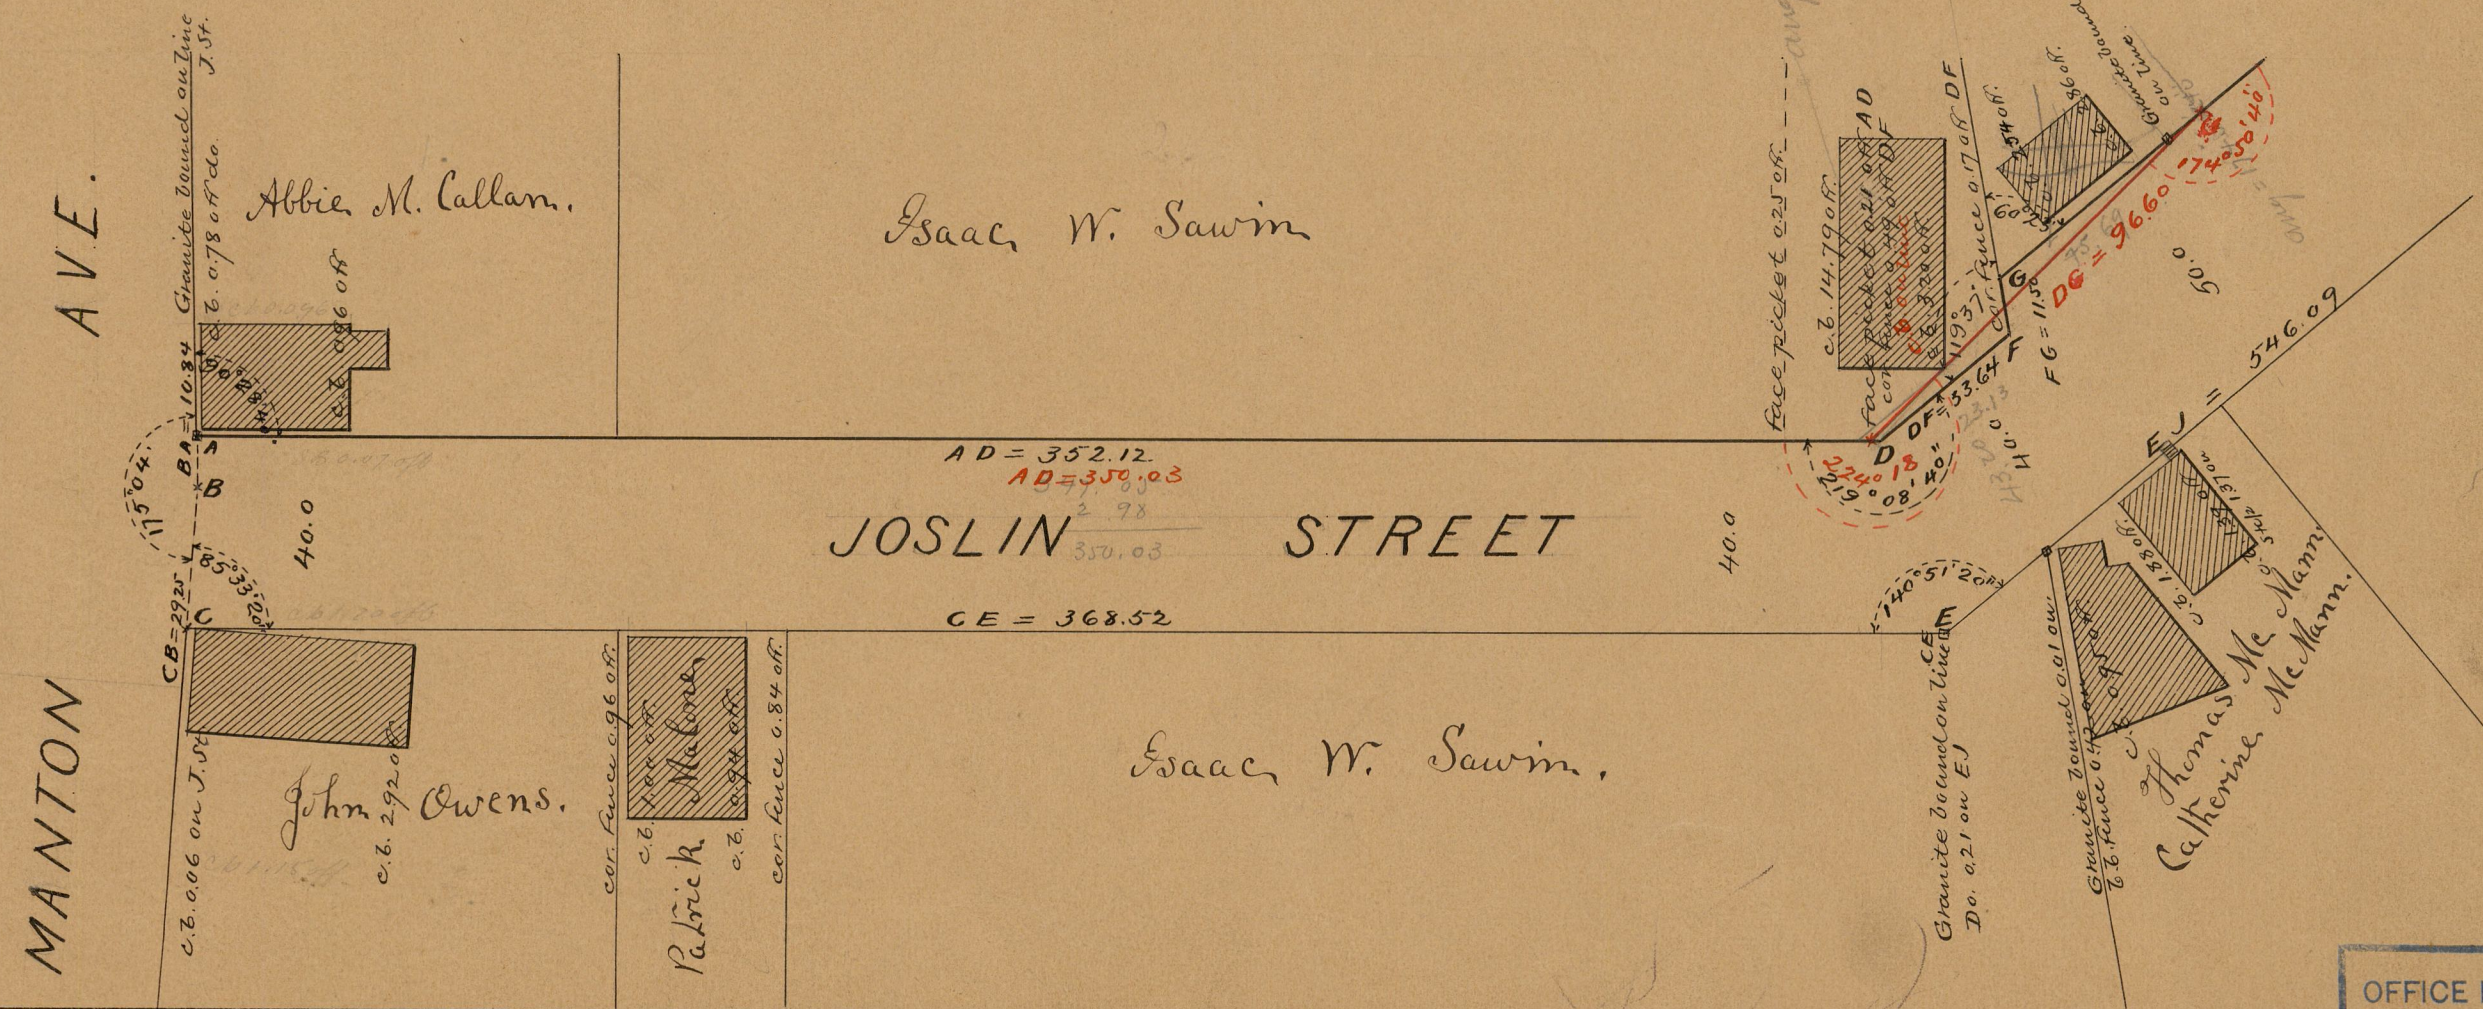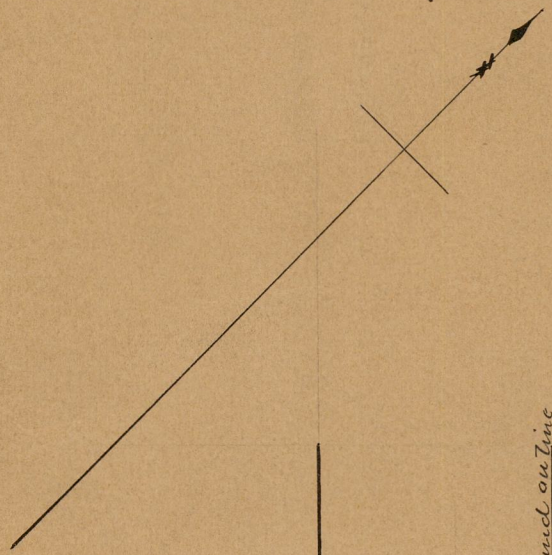

OFFICE No.	9765
DRAWER	83
SHEET	B-15