

Sept 19 1890  
-016961

Plat of  
Lay out and extension of  
Winslow Place  
from Broad St to High St.

Changed to Winslow St


Red line added Jan 18 1892.  
The red line and blue line show  
proposed changes but no action was taken.

HIGH ST.

ST.

BROAD

Scale 20 feet per inch.  
Names of owners from  
Assessors' office.

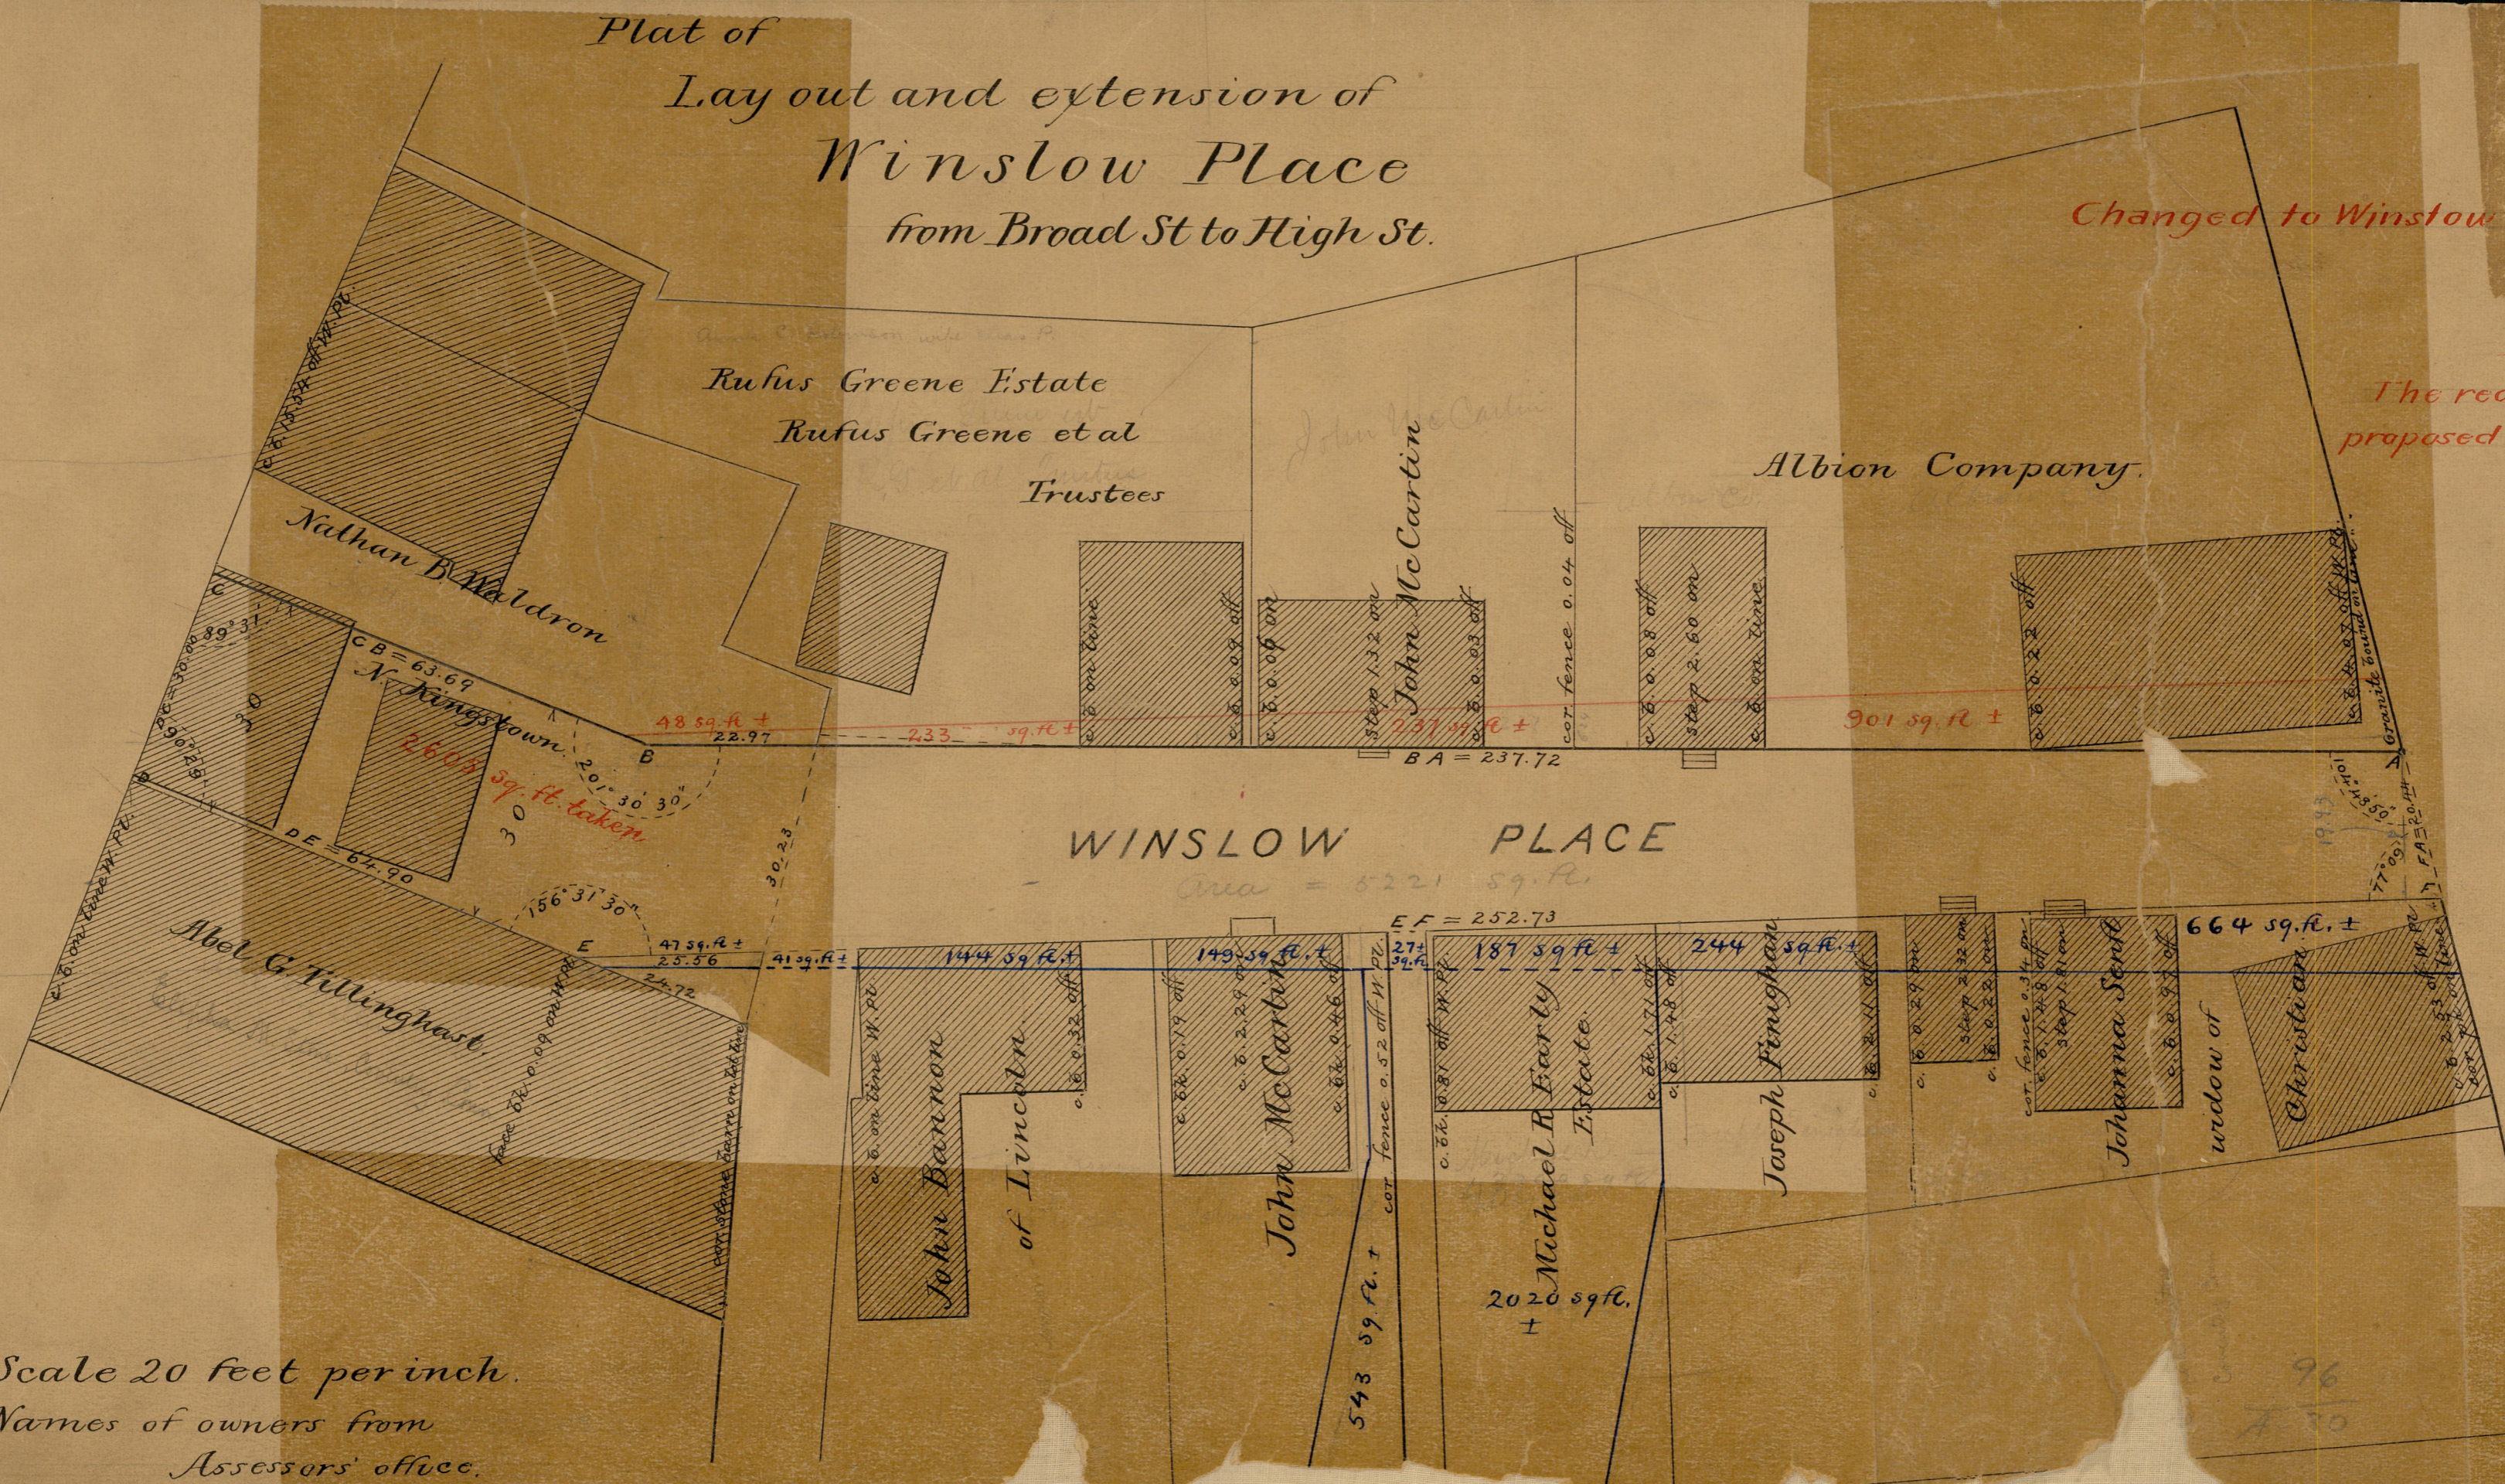

96  
A-30

OFFICE NO. 10  
DRAWN BY 56  
SCALE A-30