

**PLAT OF  
MESSER ST.**

Surveyed and drawn by order  
of the Street Commis'srs  
by C. E. PAINE

PROV AUG 1861

Scale 60 Ft. per inch

The lines figures &c in Blue ink show the line  
of Street width of sidewalk Grade &c.

Those in Red ink are Copied from Plats,  
and Records of Deeds.

City of Providence.

St Commrs Office Dec. 1861

The undersigned have caused this Plat of Messer St.  
to be made defining the lines of said St. - also showing  
the Grade, width of sidewalks as established by  
this Board

Josiah Sumner  
Edward Field  
Jm H. Townsend } Street Commrs


Copied from Plat Book 5 p. 29.

COMPARED.  
Alfred H. Combe

Scale Hor. 150 ft. per inch  
Scale Ver. 10 "  
Measurements taken along  
East line of St.

**PROFILE OF  
Messer Street**  
Made by order of the St Commrs  
By C. E. PAINE

SEPT 18 1861.

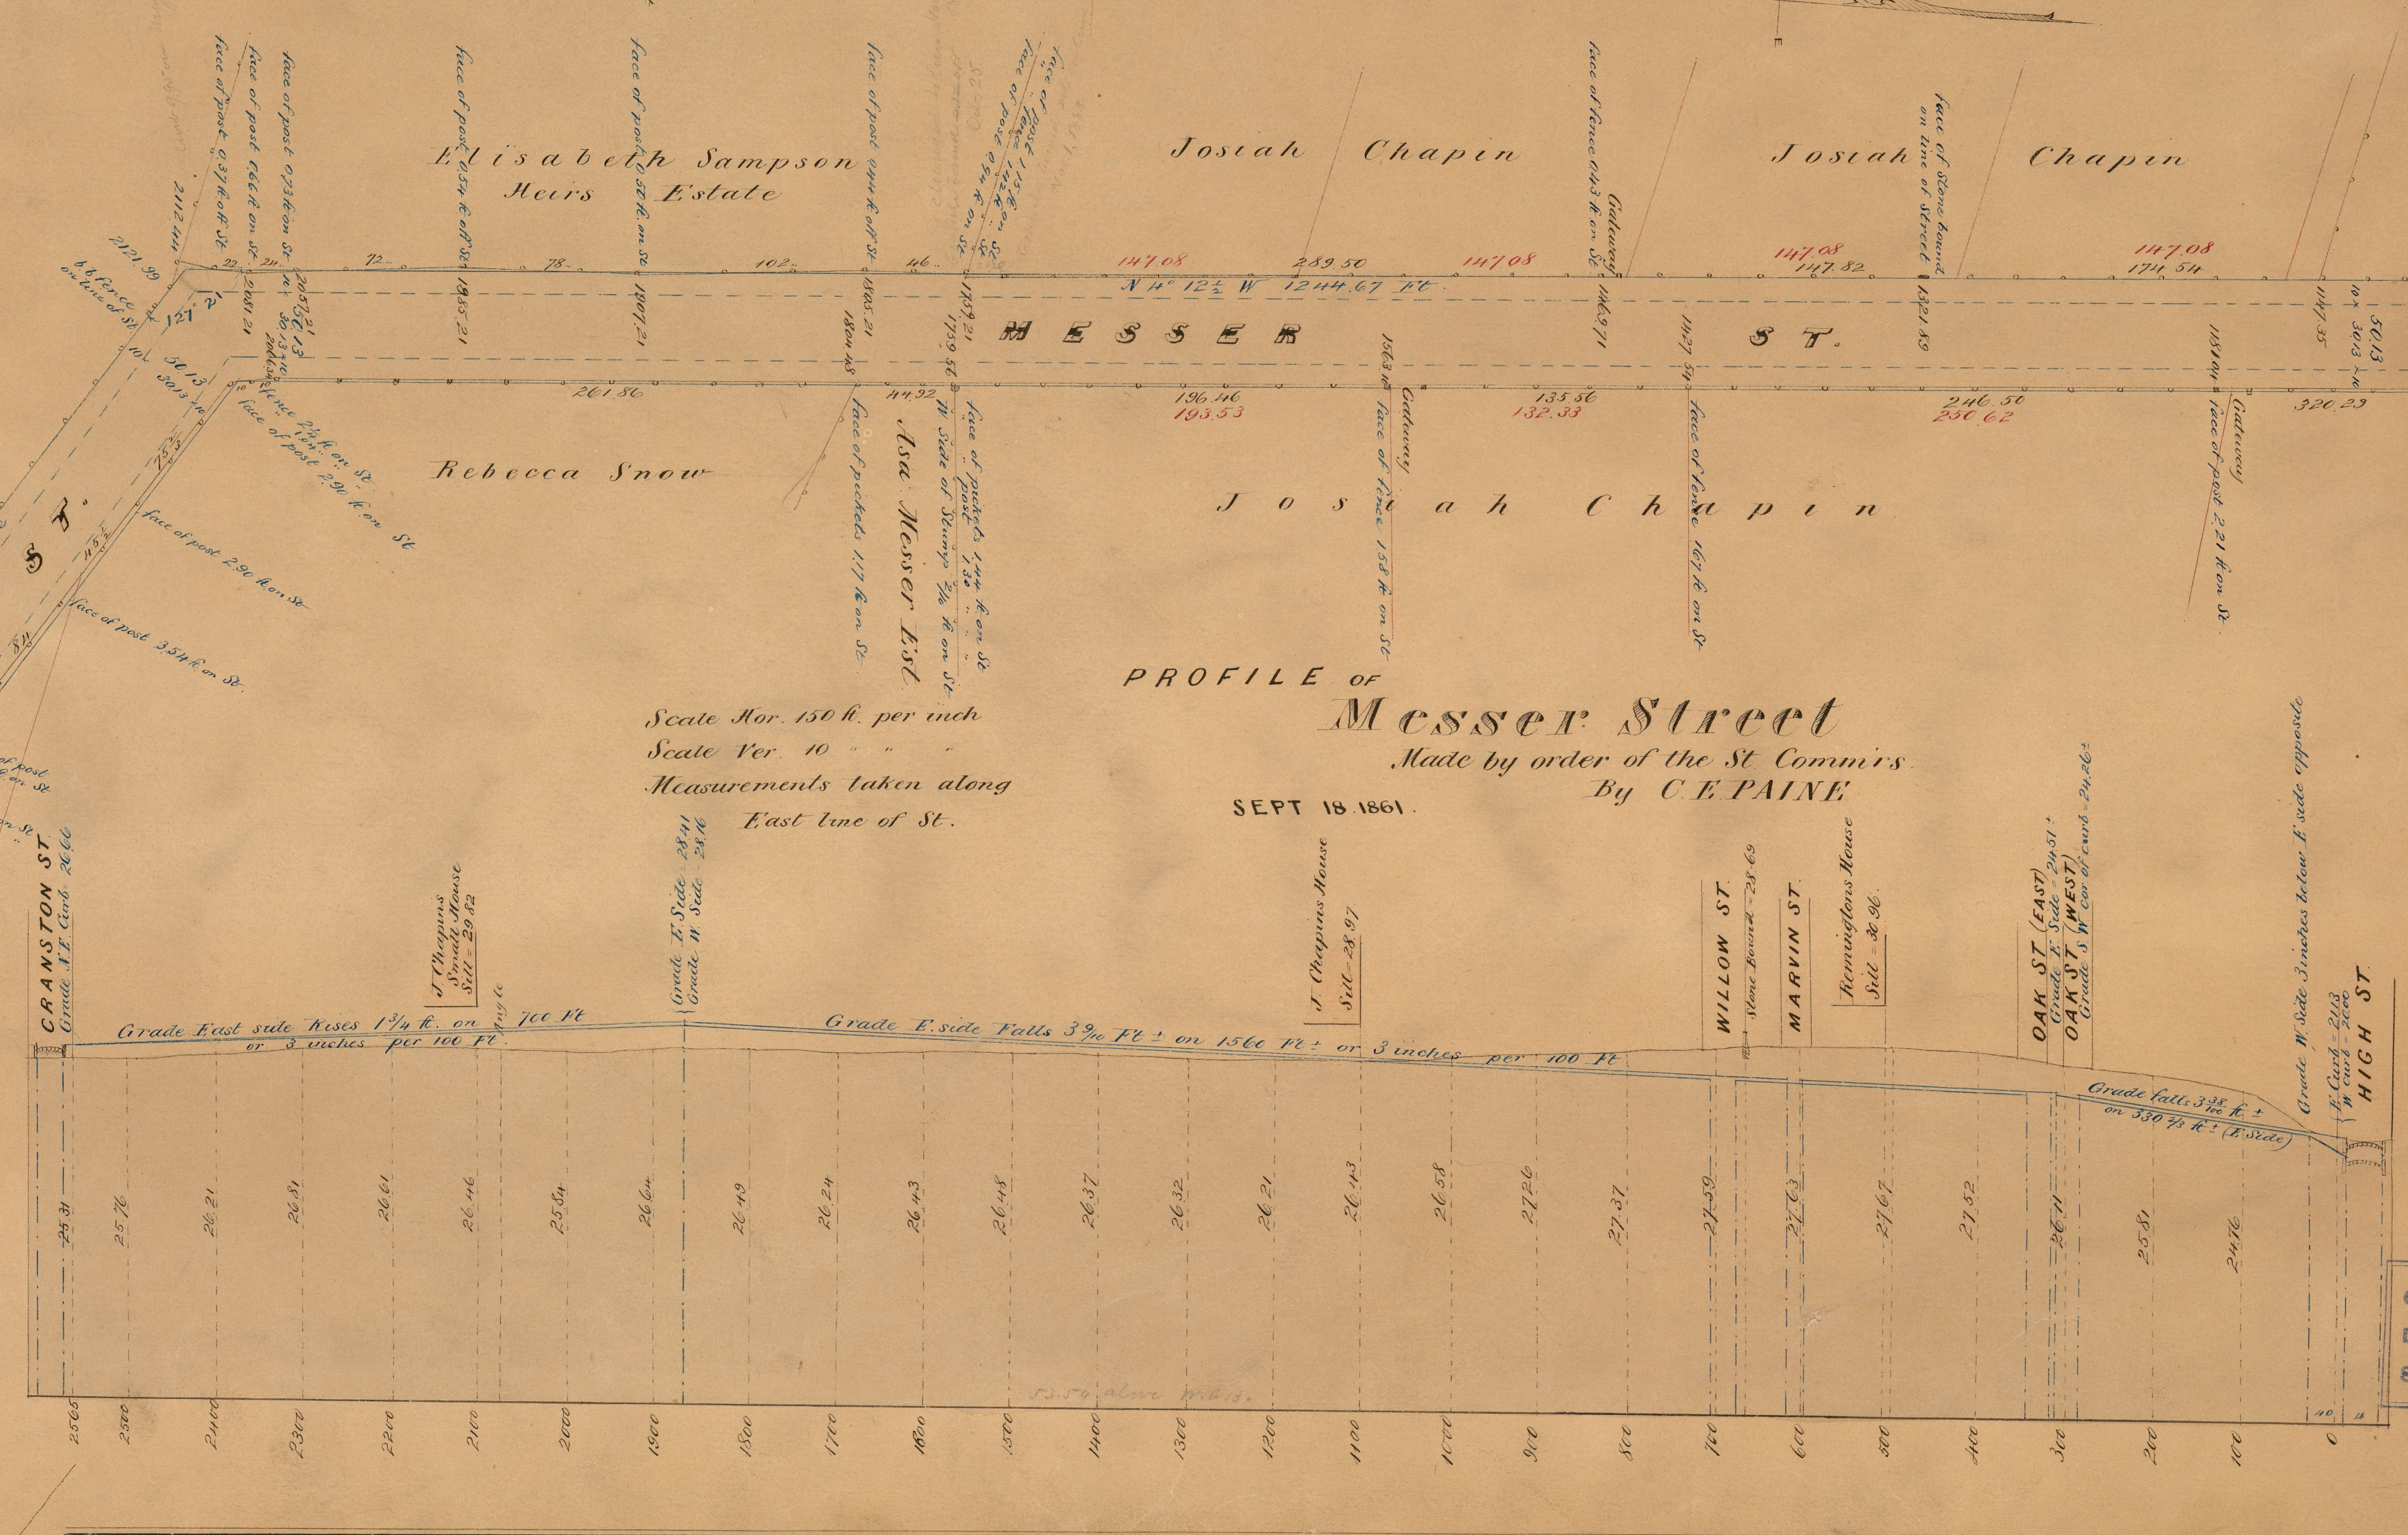

OFFICE No. 536  
DRAWER " 61  
SHEET " A-2