


Washington Street from Knight St. to Wm. Howard land, is 200 feet U.S. measure from High St. according to the deeds of lots lying between said streets. The lines of High St. as laid out by the Genl. Survey in 1787 cannot now be ascertained with certainty, from the fact that all the monuments referred to in the said deeds are lost. For the above reason the lines of High St. shown in this map are the lines of said street as laid out by the curbsmen as now set. But the north line of High Street thus defined is about 2 feet south of the average range of the fronts of the oldest buildings on that side of the Street; and as it would appear from the ground range of the buildings and fences on the part of Washington St. referred to that the proprietors had surveyed and marked out said Street by measuring (200 feet U.S. Measure) from the average of the buildings on the north side of High St. and as this appearance is confirmed by the fact that the stone found at several years since at the corner of Battery and Fountain Streets corresponds precisely therewith, and as Fountain Street as recently laid out is in conformity therewith, I have adopted for the south line of Washington Street a line parallel with and 200 feet U.S. measure from the north line of High Street as defined by the curbsmen, said line being also 200 feet U.S. measure from the average range of the fronts of said oldest buildings on the north side of High St.

Wm. S. Haines

COMPILED
By Alfred H. Condit

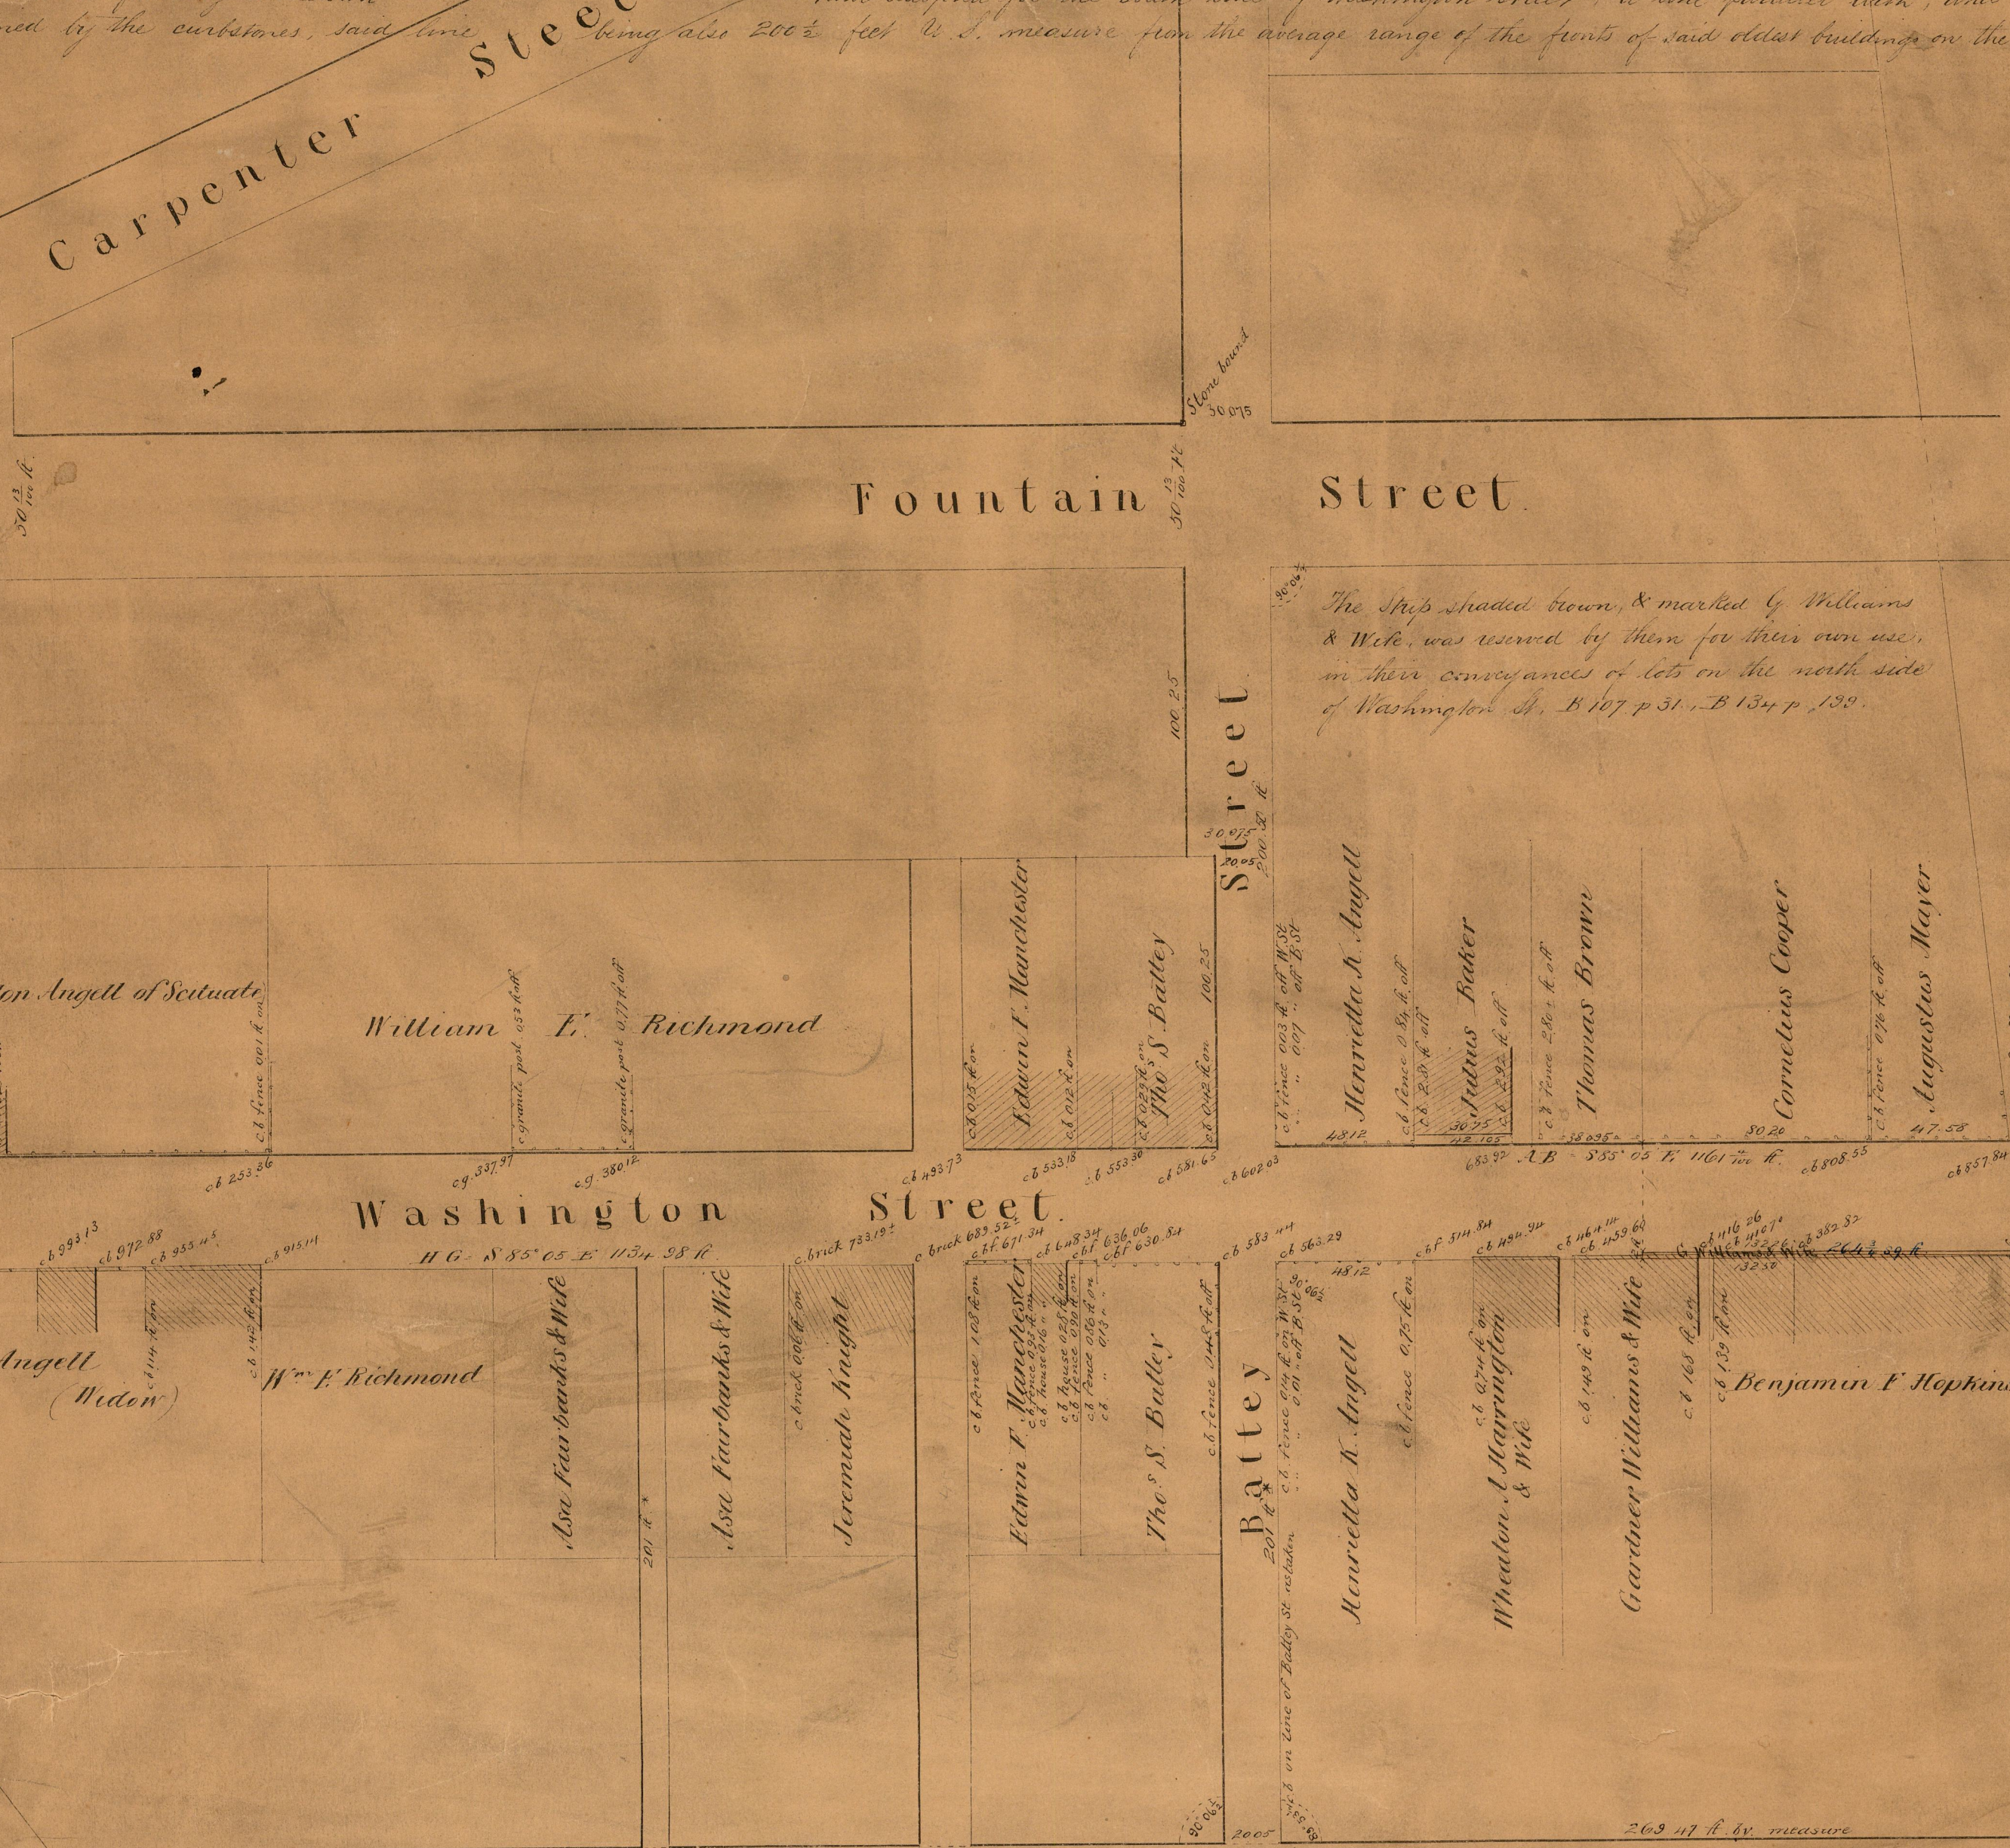

MAP
of the extension of
WASHINGTON STREET

Surveyed & drawn by order of
Geo. T. Spicer, Amasa Paine & Wm. S. Haines
a committee appointed by the
Board of Aldermen May 11th 1857
by Wm. S. Haines
July 10th 1857

Scale 50 ft to an inch.
Measure by U.S. Standard



OFFICE NO. 454
DRAWN BY 63
CHECKED BY A-27

CITY ENGINEER'S OFFICE.
STREET LINE DEPT.
July 10, 1857
0465