

That part of Lloyd St. within the lines A.V.E.C.R. was included in land taken for the Hope St. widening resolution passed Nov. 26th 1873. See also Diagram A.

Scale 50 feet per inch

This map accompanies our report of this date

Copied from St. Plat Book B. page 39.

Providence Feb 14, 1874

Robert Sherman
James W. Bowen
James W. Blackwood
Commissioners.

PLAN
of proposed extension of
LLOYD ST.

FROM
HOPE ST. & ARLINGTON AVE.


as laid out by
Robert Sherman Anos W Snow, Joseph G Johnson
William H Bowen & James W Blackwood

Commissioners appointed
by the Hon Supreme Court
March term 1873.

Made by
C.E. PAINE

City Engineer

NOV. 27 1873.

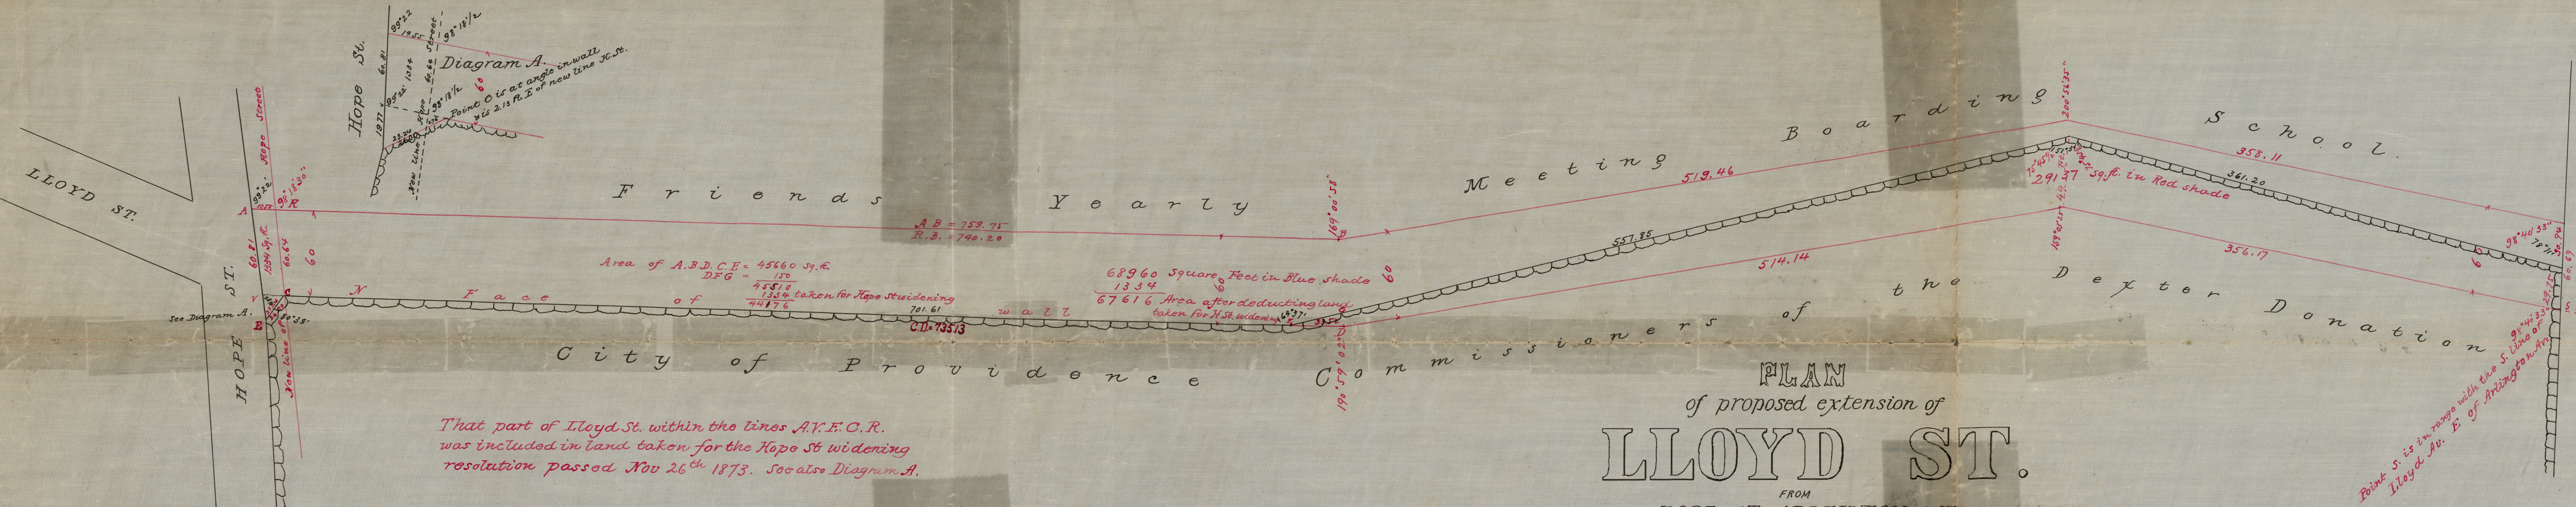

That part of Lloyd St. within the lines A.V.F.C.R. was included in land taken for the Hope St widening resolution passed Nov 26th 1873. See also Diagram A.

Scale 50 feet per inch
 Copied from St. Plat Book B page 39.

This map accompanies our report of this date
 Providence Feb 14 1874.

Robert Sherman
 Amos W. Snow
 William H. Bowen
 James W. Blackwood
 Commissioners

PLAN
 of proposed extension of
LLOYD ST.

FROM
 HOPE ST. to ARLINGTON AVE.
 as laid out by
 Robert Sherman, Amos W. Snow, Joseph G. Johnson
 William H. Bowen & James W. Blackwood

Commissioners appointed
 by the Hon Supreme Court
 March term 1873

Made by
 C.E. PAINE
 City Engineer Nov. 27, 1873

Point S is in range with the S. line of Lloyd Av. E. of Arlington Av.