Sheet No. 3 OK
Dexter Donation Property in 11 Sheets

Offsets in Green Ink added Sept. 15, 1924
F.B. 2385/80

P.B. 18 p 1

PROVIDENCE, R.I.
CITY ENGINEER'S OFFICE
CITY PROPERTY DEPT.

MAP OF DOYLE AVE. LOTS.

FROM CAMP ST. TO EAST AVENUE

Scale 50 ft. per inch

MAY 10, 86.

011896

(Dec. 4. 1886 012388) on record card 580

On record map stone bound and no offsets are shown See card 580.

Use blue figures. Stone bounds placed Dec. 1886.

The black offsets from A to C refer to the red line and not the black one. blue figures added May 29, 1886.

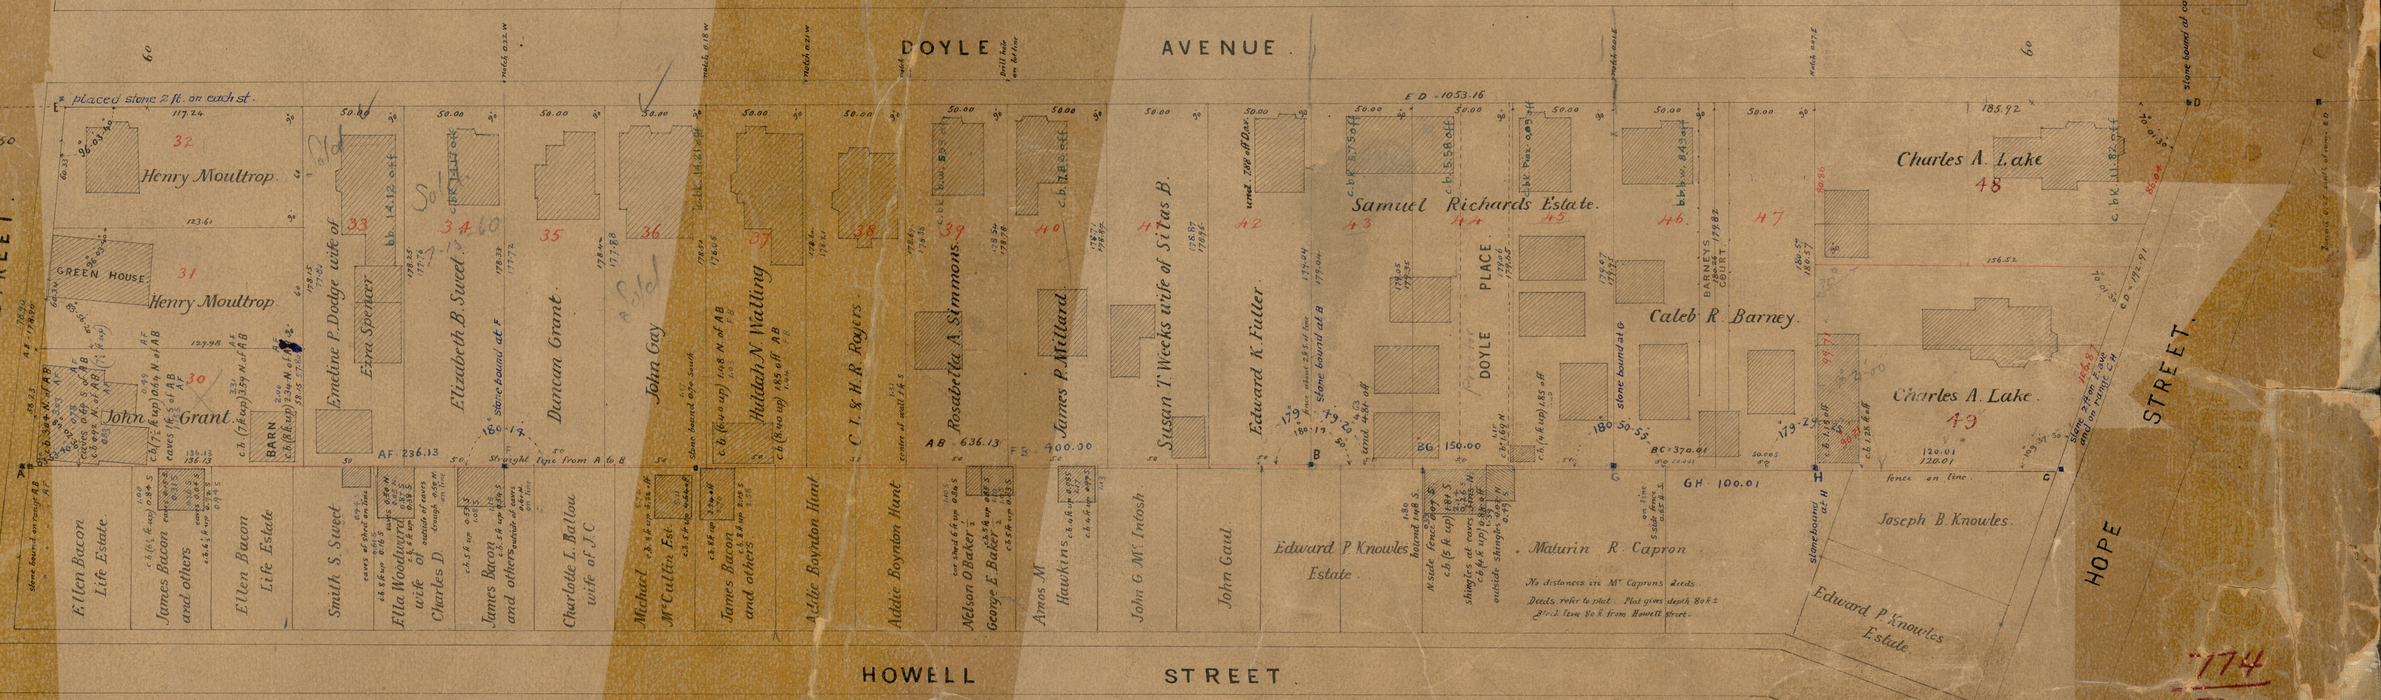

774/50

774