Providence, R.I.
This plat accompanies
our report of this date.

PLAT OF

STANIFORD STREET

FROM PUBLIC ST. TO WILLARD AVE.

SCALE 60 FEET PER INCH

PROVIDENCE, R. I.
CITY ENGINEER'S OFFICE
STREET LINE DEP'T.
Aug. 18, 1890
016800

Red lines & notes indicate
lay out

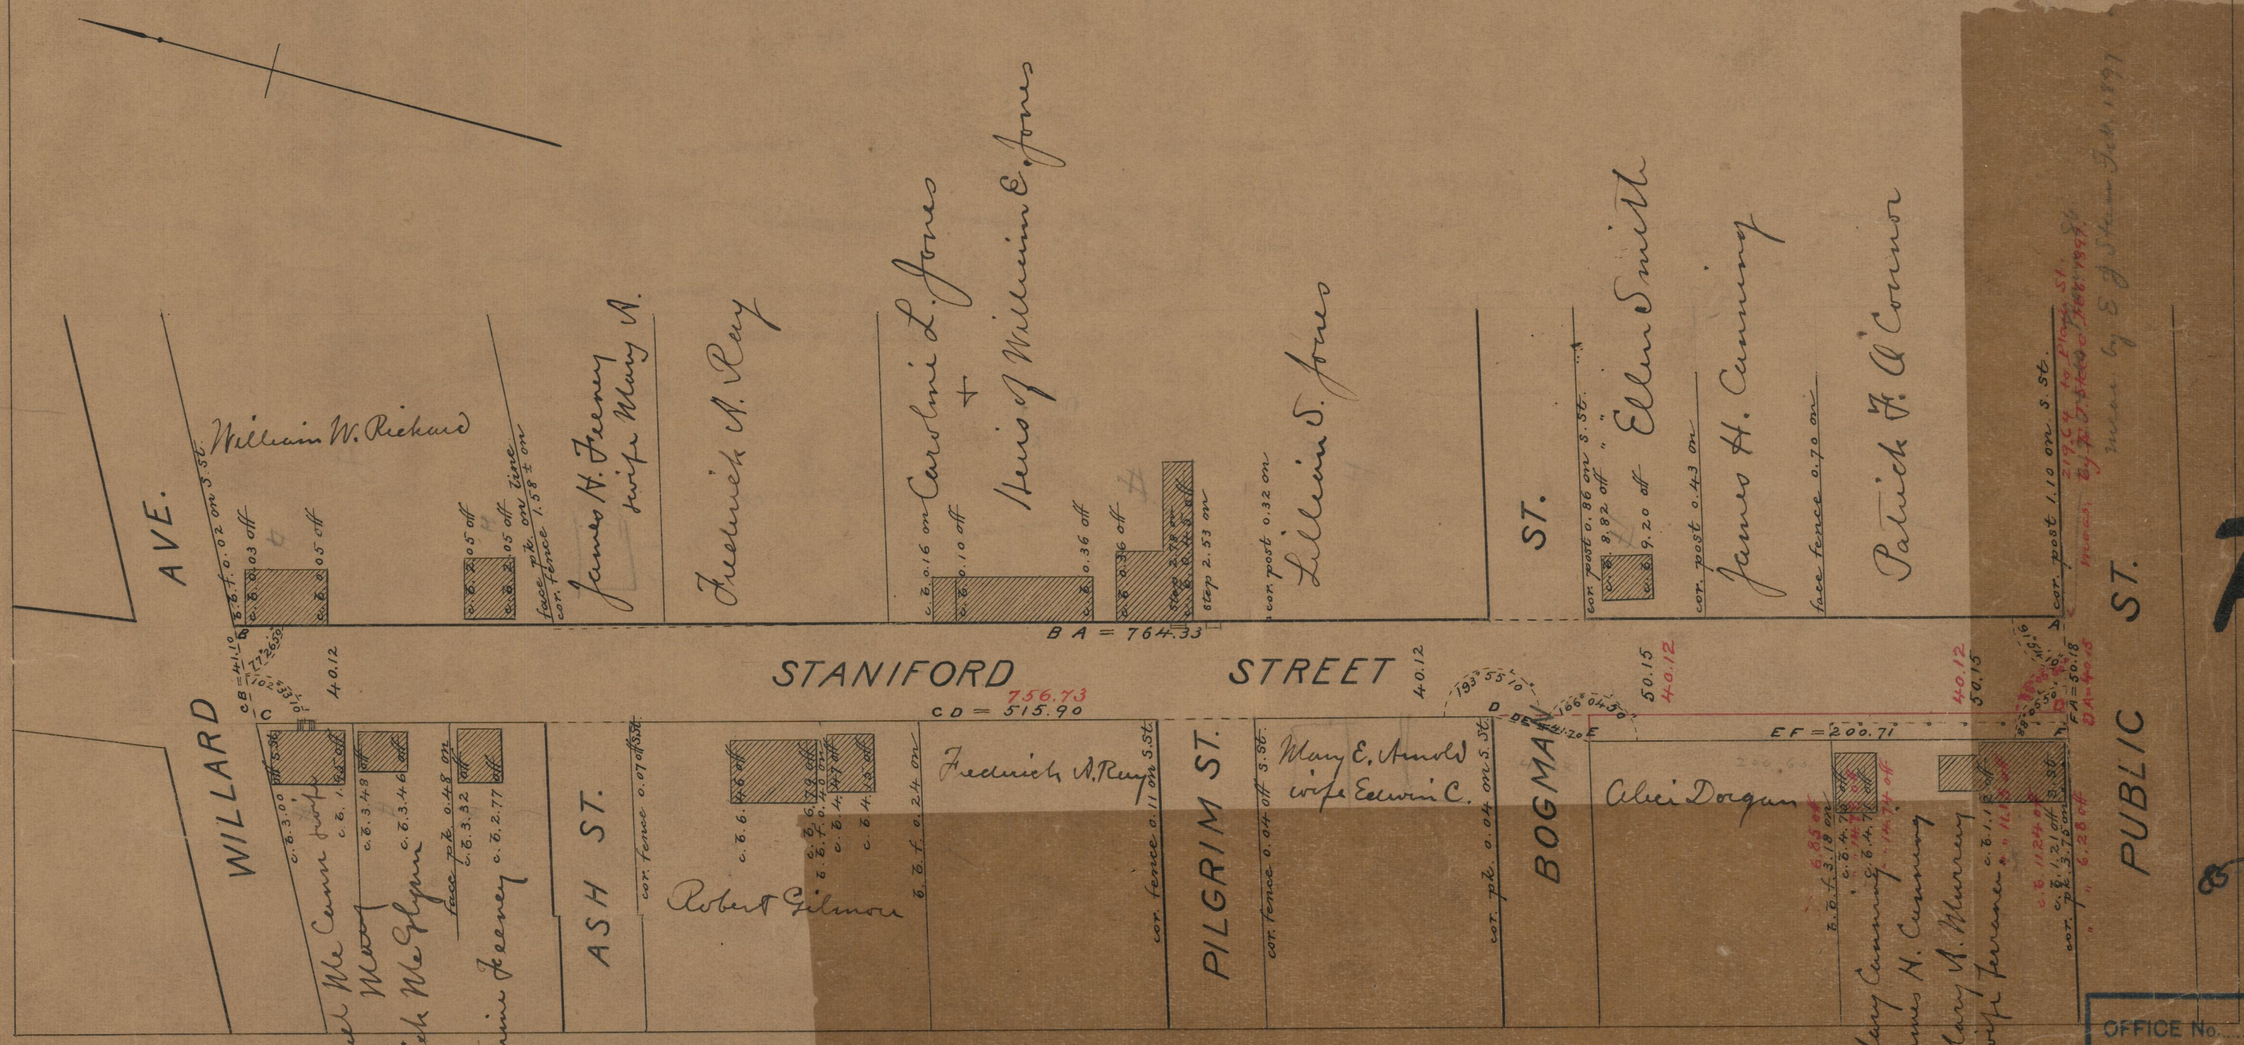

85
A-81

85
A-81

85 A-81

OFFICE No. 10
DRAWER
SHE