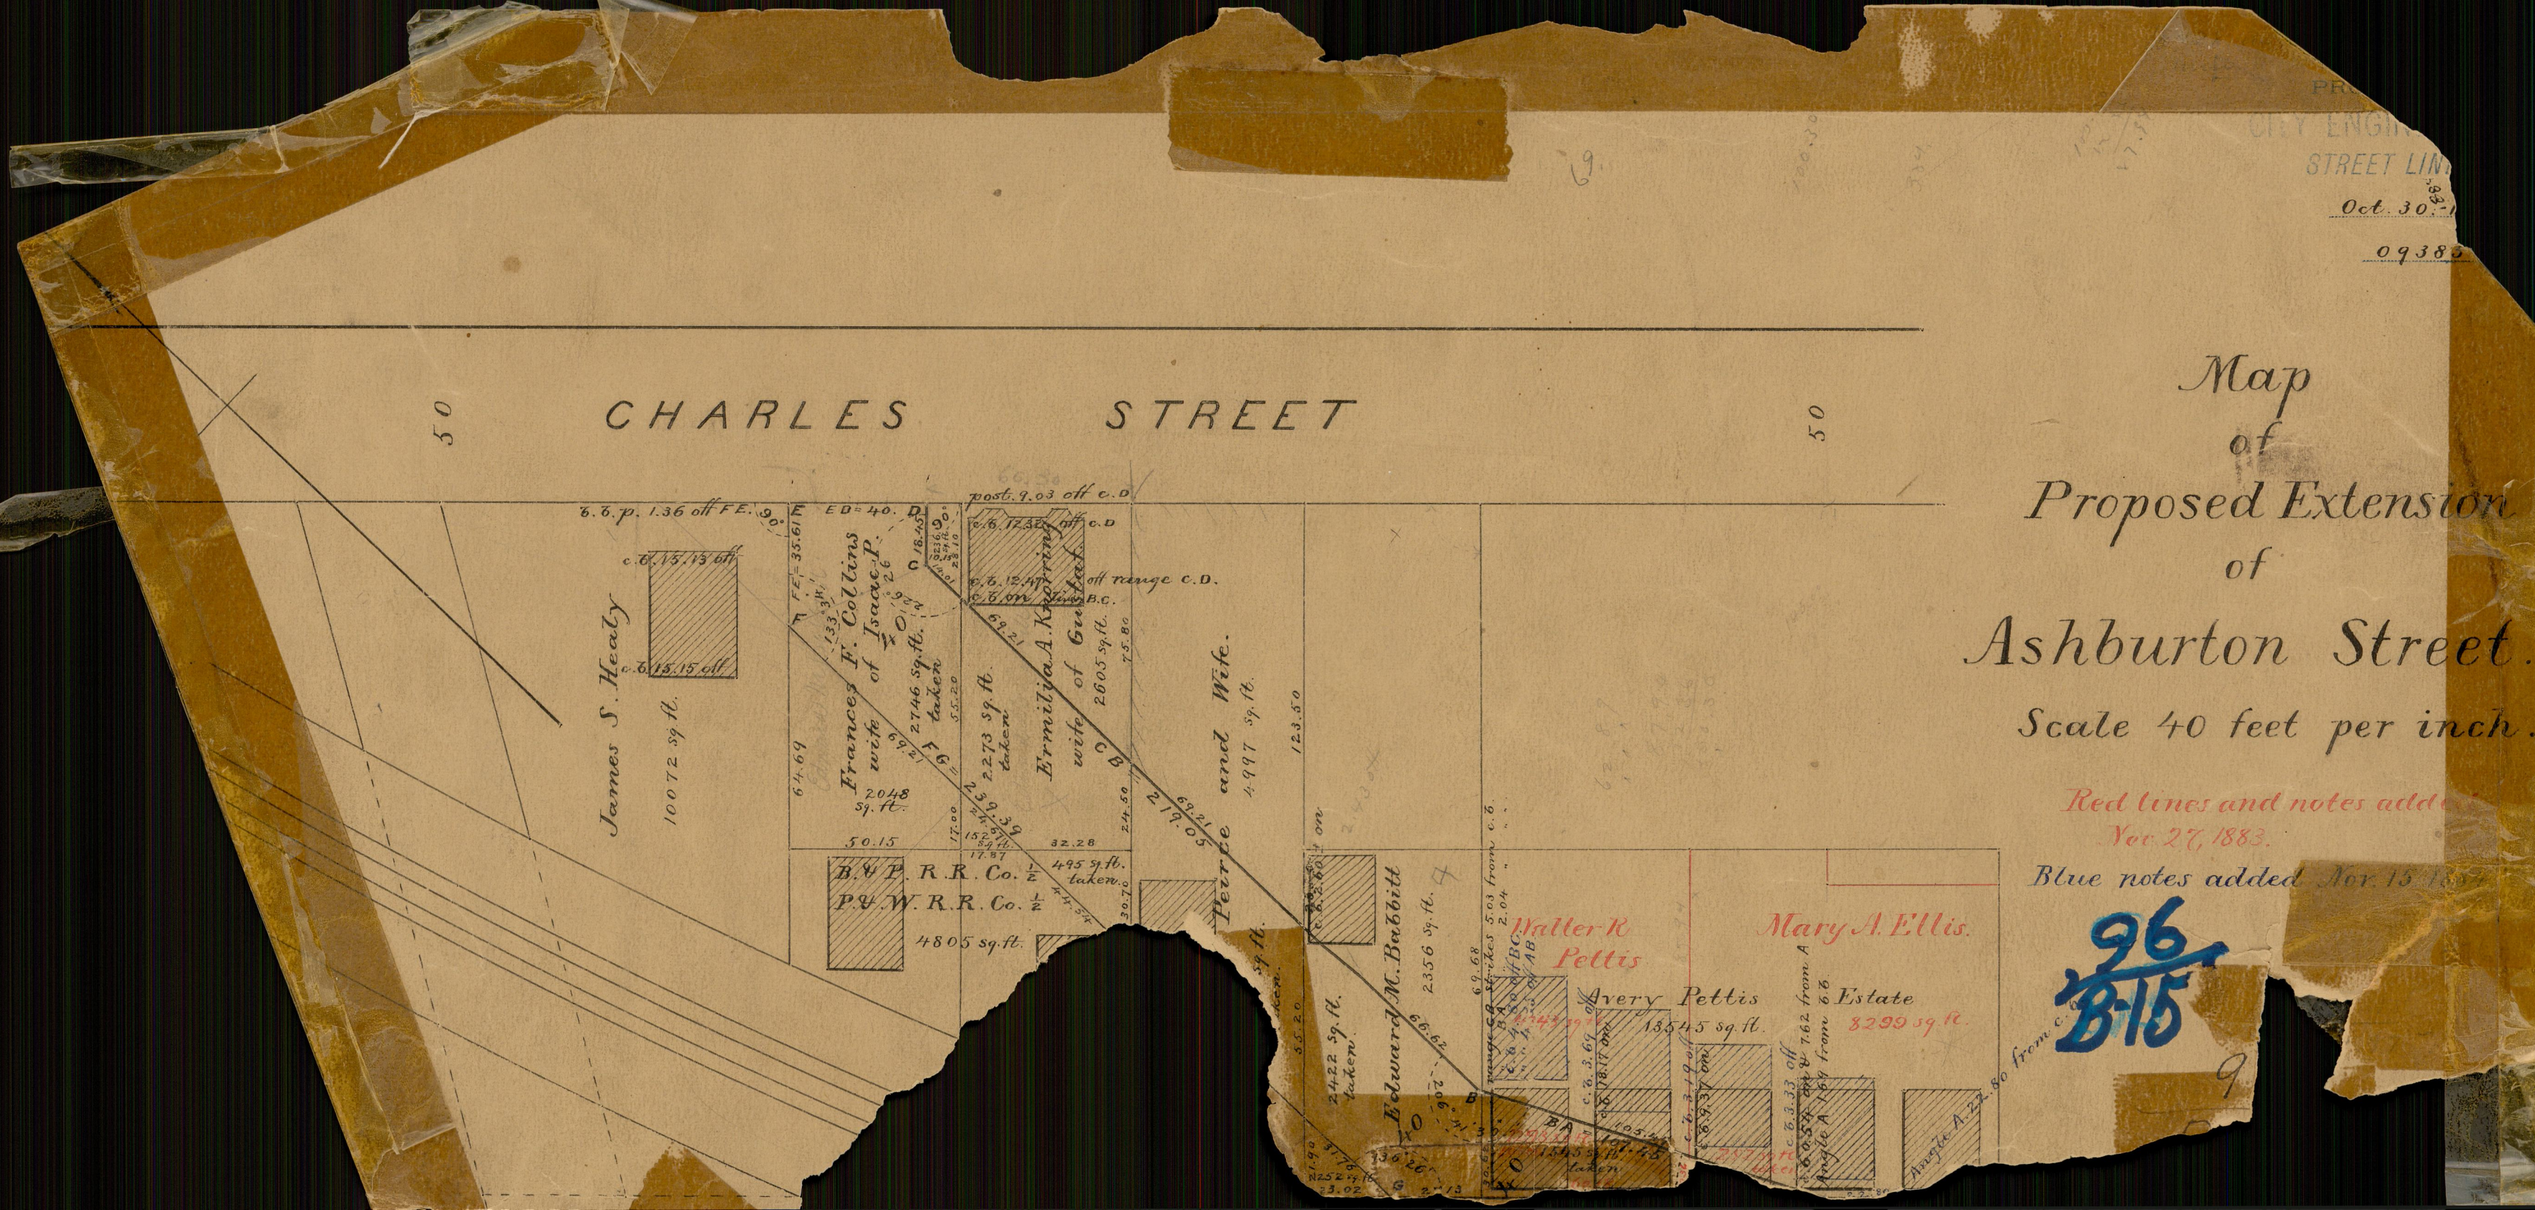

Map
of
Proposed Extension
of
Ashburton Street.
Scale 40 feet per inch.
Red lines and notes added
Nov. 27, 1883.
Blue notes added Nov. 15
CHARLES STREET
50
50
James S. Healy
10072 sq. ft.
Frances F. Collins
wife of Isaac P.
2746 sq. ft. taken
2048 sq. ft.
Ermilia A. Knorring
wife of Gustaf
2605 sq. ft.
2273 sq. ft. taken
Peirce and Wife.
4997 sq. ft.
B. & P. R.R. Co. ½
P. & W. R.R. Co. ½
4805 sq. ft.
495 sq. ft. taken.
Edward M. Babbitt
2356 sq. ft.
2422 sq. ft. taken.
Walter R. Pettis
Avery Pettis
13545 sq. ft.
Mary A. Ellis.
Estate
8299 sq. ft.
Oct. 30.
09385
96
B-15